

VICINITY MAP
NTS

PLANT SCHEDULE & MATERIALS

COMMON NAME	QUANTITY
VITEX	23
CEDAR ELM	7
LACEBARK ELM	16
REDBUD	2
MEXICAN PLUM	2
CHINESE PISTACHE	3
LIVE OAK	1
SHRUBS	
⊗ DWARF BURFORD HOLLY	72
○ DWARF YAUPON HOLLY	6
⊗ MAIDENHAIR GRASS	20
⊗ RED YUCCA	28
⊗ REGAL MIST MUHLY	28
⊗ AUTUMN SAGE	13
⊗ DWARF WAX MYRTLE	11
⊗ TEXAS SAGE	17
⊗ SUNSHINE LIGUSTRUM	12
⊗ MEXICAN FEATHER GRASS	74
GROUND COVER	
⊗ PURPLE WINTER CREEPER	
⊗ DECOMPOSED GRANITE	
EXISTING TREES	
○ LARGE CANOPY	
○ SMALL CANOPY/ORNAIMENTAL	

APPROVED REPLACEMENT PLANT MATERIAL LIST

LARGE TREES; Min. 2" CALIPER; Min. 12' HEIGHT		MEDIUM TREES; Min. 2" CALIPER; Min. 10' HEIGHT		SMALL TREES Min. 2" CALIPER; Min. 8' HEIGHT	
COMMON NAME	SCIENTIFIC NAME	COMMON NAME	SCIENTIFIC NAME	COMMON NAME	SCIENTIFIC NAME
ASH, GREEN	<i>Fraxinus pennsylvanica</i>	ASH, TEXAS	<i>Fraxinus texensis</i>	ACACIA, WRIGHT	<i>Acacia greggii</i> var. <i>wrightii</i>
ASH, FAN-TEX	<i>Fraxinus velutina</i> 'Fan Tex'	ELM, BOSQUE	<i>Ulmus parvifolia</i> 'Bosque'	BUCKEYE, MEXICAN	<i>Ungnadia speciosa</i>
BALDYPRESS	<i>Taxodium distichum</i>	ELM, WINGED	<i>Ulmus alata</i>	BUCKEYE, RED	<i>Aesculus pavia</i>
BOXELDER	<i>Acer negundo</i>	GINGKO (MALE)	<i>Ginkgo biloba</i>	CHERRY-LAUREL	<i>Prunus caroliniana</i>
CATALPA	<i>Catalpa bignonioides</i>	GOLDENRAIN TREE	<i>Koeleruteria paniculata</i>	CHITALPA	<i>Chitalpa tashkentensis</i>
DEODAR CEDAR	<i>Cedrus deodara</i>	HICKORY, BLACK	<i>Carya texana</i>	CRABAPPLE, FLOWERING	<i>Malus spp.</i>
ELM, AMERICAN	<i>Ulmus americana</i>	HONEYLOCUST, THORNLESS	<i>Gleditsia triacanthos</i>	CREPE MYRTLE	<i>Lagerstroemia spp.</i>
ELM, CEDAR	<i>Ulmus crassifolia</i>	JUJUBE	<i>Ziziphus jujuba</i>	DESERT WILLOW	<i>Chilopsis linearis</i>
ELM, LACEBARK	<i>Ulmus parvifolia</i>	KENTUCKY COFFEETREE	<i>Gymnocladus dioica</i>	DOGWOOD	<i>Cornus florida</i>
GUM BUMELIA	<i>Bumelia lanuginosa</i>	MAPLE, AUTUMN BLAZE	<i>Acer X freemanii</i>	DOGWOOD, ROUGHLEAF	<i>Cornus drummondii</i>
LINDEN TREE	<i>Tilia americana</i>	MAPLE, BIGTOOTH	<i>Acer grandidentatum</i>	EVE'S NECKLACE	<i>Sophora affinis</i>
MAGNOLIA, SOUTHERN	<i>Magnolia grandiflora</i>	MAPLE, CADDO	<i>Acer barbatum</i> var. <i>caddo</i>	EDIBLE FIG	<i>Ficus carica</i>
OAK, BUR	<i>Quercus macrocarpa</i>	MAPLE, OCTOBER GLORY	<i>Acer rubrum</i>	FRINGETREE	<i>Chionanthus virginicus</i>
OAK, CHINKAPIN	<i>Quercus muehlenbergii</i>	MAPLE, TRIDENT	<i>Acer buergerianum</i>	HAWTHORN	<i>Crataegus spp.</i>
OAK, DURAND	<i>Quercus durandii</i>	MESQUITE, HONEY	<i>Prosopis glandulosa</i>	HOLLY, AMERICAN	<i>Ilex opaca</i>
OAK, LIVE	<i>Quercus virginiana</i>	OAK, BLACKJACK	<i>Quercus marilandica</i>	HOLLY, 'NELLIE R. STEVENS'	<i>Ilex x Nellie R Stevens</i>
OAK, MEXICAN	<i>Quercus polymorpha</i>	OAK, ESCARPMENT	<i>Quercus fusiformis</i>	HOLLY, 'SAVANNAH'	<i>Ilex x attenuata</i> 'Savannah'
OAK, POST	<i>Quercus stellata</i>	OAK, LACEY	<i>Quercus laceyi</i>	HOLLY, POSSUMHAW	<i>Ilex decidua</i>
OAK, SHUMARD	<i>Quercus shumardii</i>	OAK, VASEY	<i>Q. pungens</i> var. <i>Vaseyana</i>	HOLLY, YAUPON	<i>Ilex vomitoria</i>
OAK, WHITE	<i>Quercus alba</i>	PINE, AUSTRIAN	<i>Pinus nigra</i>	JUNIPER, ASH	<i>Juniperus ashei</i>
PECAN	<i>Carya illinoensis</i>	PINE, JAPANESE BLACK	<i>Pinus thunbergii</i>	VITEX TREE	<i>Vitex agnus-castus</i>
PINE, LOBLOLLY	<i>Pinus taeda</i>	PISTACHE, CHINESE	<i>Pistacia chinensis</i>	MAGNOLIA, 'LITTLE GEM'	<i>Manolia grandiflora</i> 'Little Gem'
PINE, ITALIAN STONE	<i>Pinus pinea</i>	REDBUD, EASTERN	<i>Cercis canadensis</i>	MAGNOLIA, SAUCER	<i>Manolia soulangeana</i>
PINE, SLASH	<i>Pinus elliotii</i>	REDBUD, TEXAS	<i>C. canadensis</i> var. <i>texensis</i>	MEXICAN PLUM	<i>Prunus mexicana</i>
PONDYPRESS	<i>Taxodium ascendens</i>	REDBUD, MEXICAN	<i>C. canadensis</i> var. <i>mexicana</i>	MOUNTAIN LAUREL, TEXAS	<i>Sophora secundiflora</i>
SUGARBERRY	<i>Celtis laevigata</i> var. <i>laevigata</i>	REDCEDAR, EASTERN	<i>Juniperus virginiana</i>	PINE, AFGHAN	<i>Pinus eldarica</i>
SYCAMORE	<i>Platanus occidentalis</i>	RIVER BIRCH	<i>Betula nigra</i>	PLUM, WILD GOOSE	<i>Prunus munsoniana</i>
SYCAMORE, MEXICAN	<i>Platanus mexicana</i>	RIVER BIRCH, DURA-HEAT	<i>B. nigra</i> 'Dura Heat'	RUSTY, BLACKHAW	<i>Viburnum rufidulum</i>
WALNUT, BLACK	<i>Juglans nigra</i>	SOAPBERRY, WESTERN	<i>Sapindus drummondii</i>	SMOKETREE, EUROPEAN	<i>Cotinus coggygria</i>
WILLOW, BLACK	<i>Salix nigra</i>	AMERICAN SMOKETREE	<i>Cotinus obovatus</i>	WAX-MYRTLE, SOUTHERN	<i>Myrica cerifera</i>
		SWEETGUM	<i>Liquidambar styraciflua</i>	WILD OLIVE	<i>Cordia boissiere</i>
		WALNUT, TEXAS BLACK	<i>Juglans microcarpa</i>		

ADDITIONAL REPLACEMENT MATERIAL


COMMON NAME	SCIENTIFIC NAME
PURPLE LEAF WINTER CREEPER	<i>Euonymus colorata</i>
CREPE MYRTLE	<i>Lagerstroemia indica</i>
COMMON BERMUDA	<i>Cynodon dactylon</i>



1

'AS-BUILT' LANDSCAPE PLAN

SCALE: 1" = 30'-0"

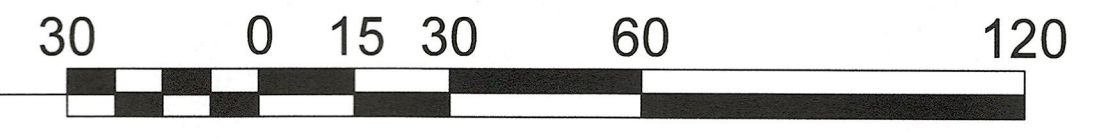

10/28/2020
PROJECT NUMBER
CASE NUMBER
landscape plan

BALDWIN ASSOCIATES
3904 Elm Street, Suite B
Dallas, Texas 75226
MOBILE: 214.729.7949
OFFICE: 214.824.7949
rob@baldwinplanning.com

Baldwin Associates

MOCKINGBIRD & ABRAMS
CITY OF DALLAS, TEXAS